

Shelby Street Bridge

Brothers Lane Bridge



Shelby St

E Alameda St

E Alameda St

Santa Fe River

Santa Fe River

Santa Fe River

Santa Fe River

5.26.1951






11.10.1958




8.16.1960



2.27.1969

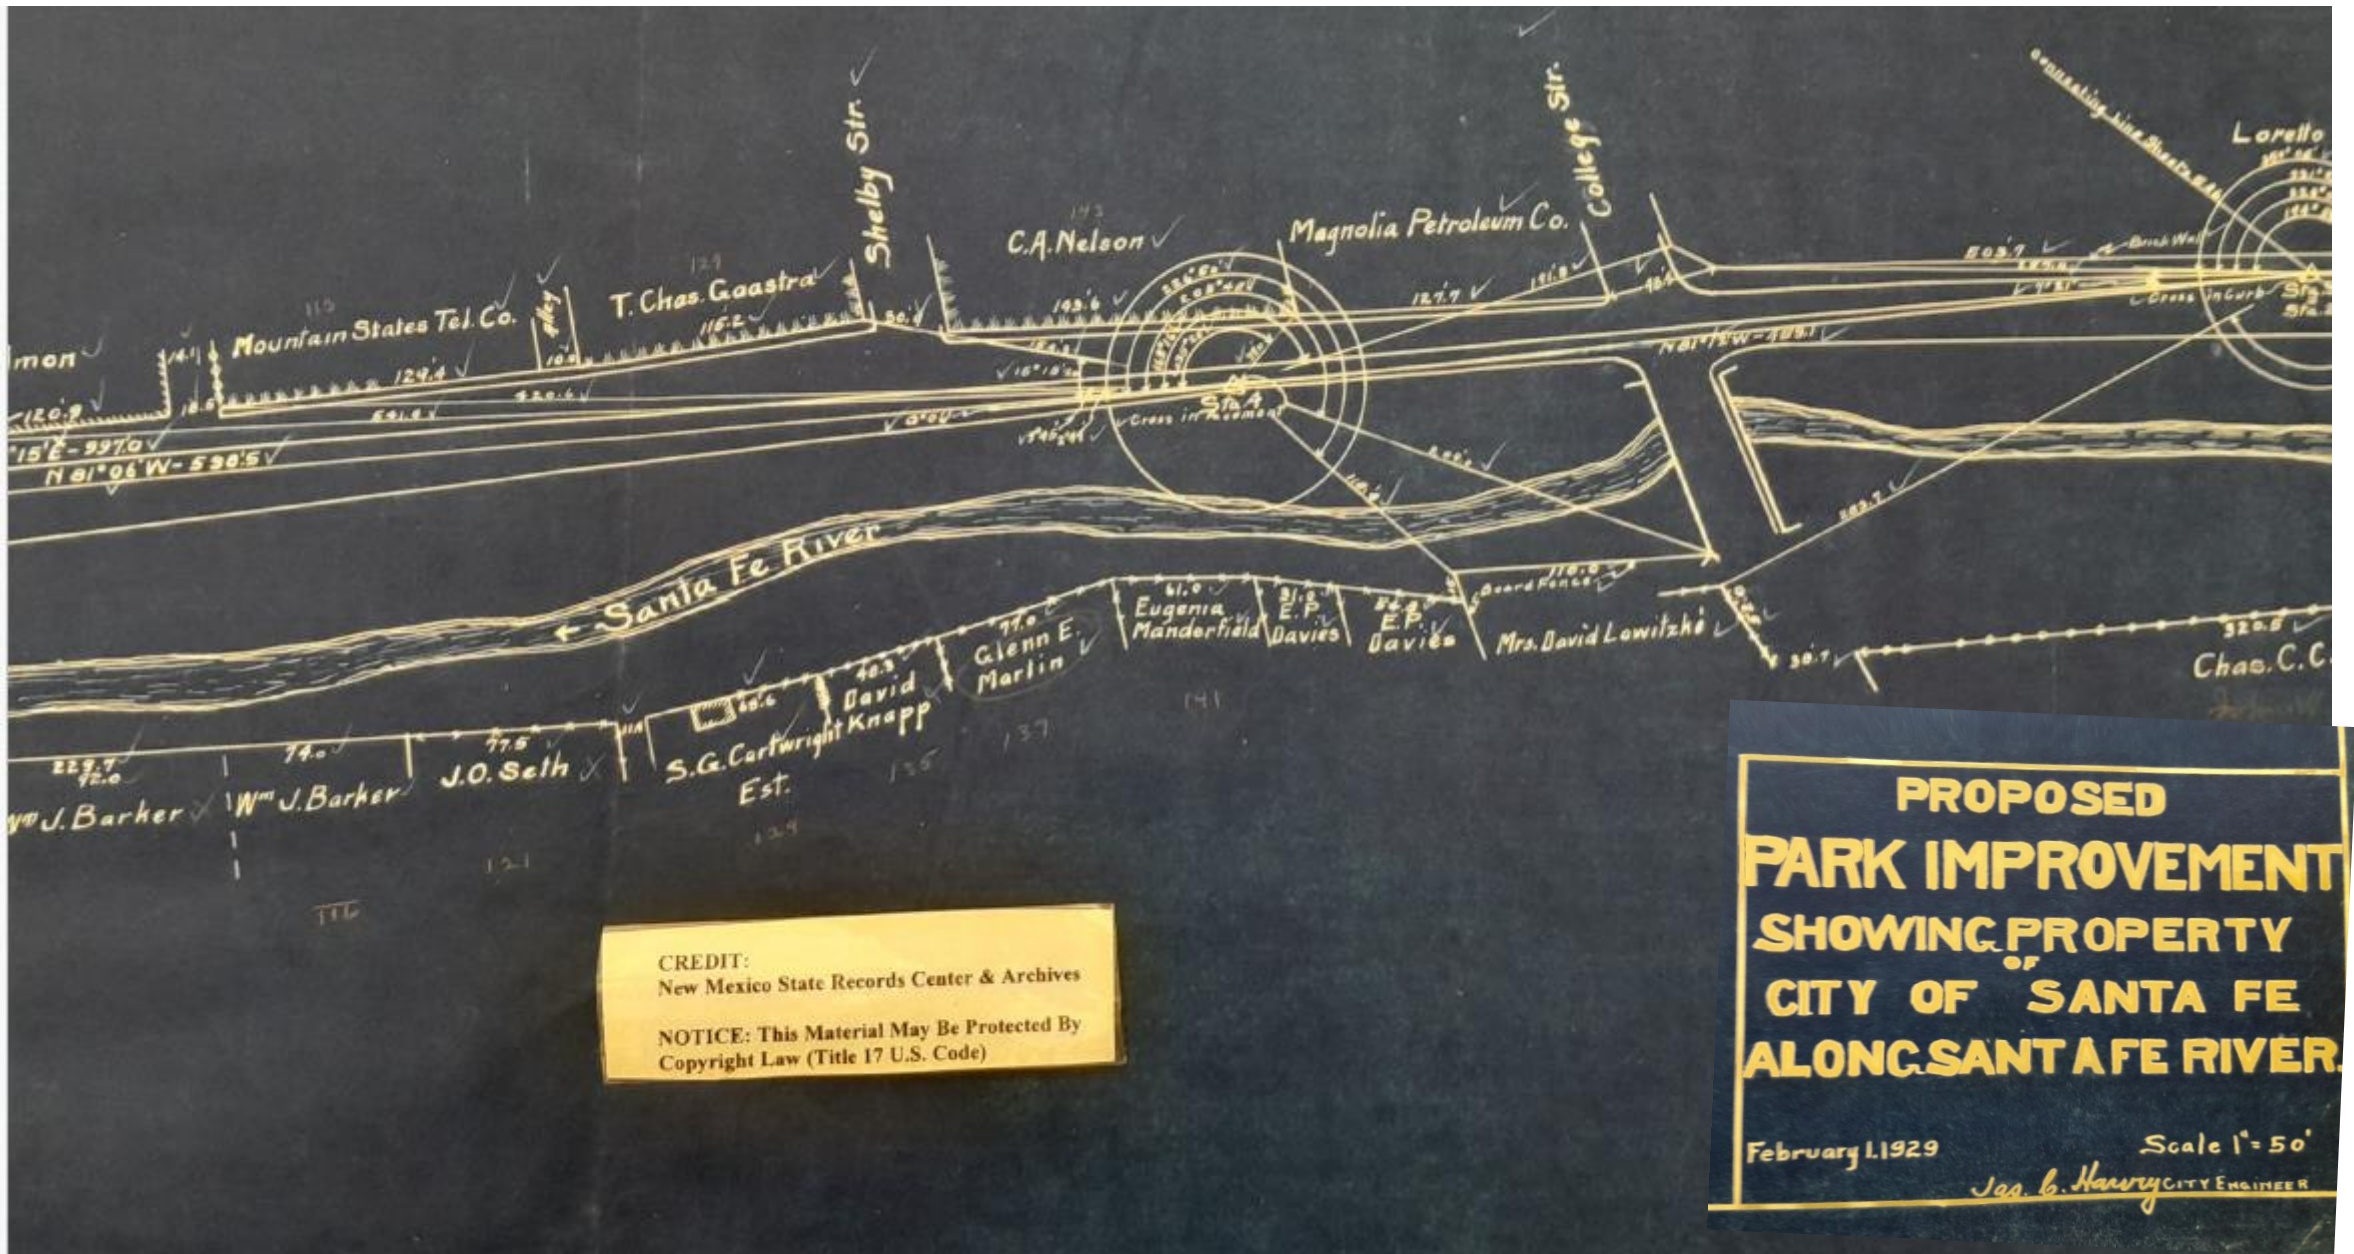

Plans from February 1929 project does not show the footbridge as part of the plan

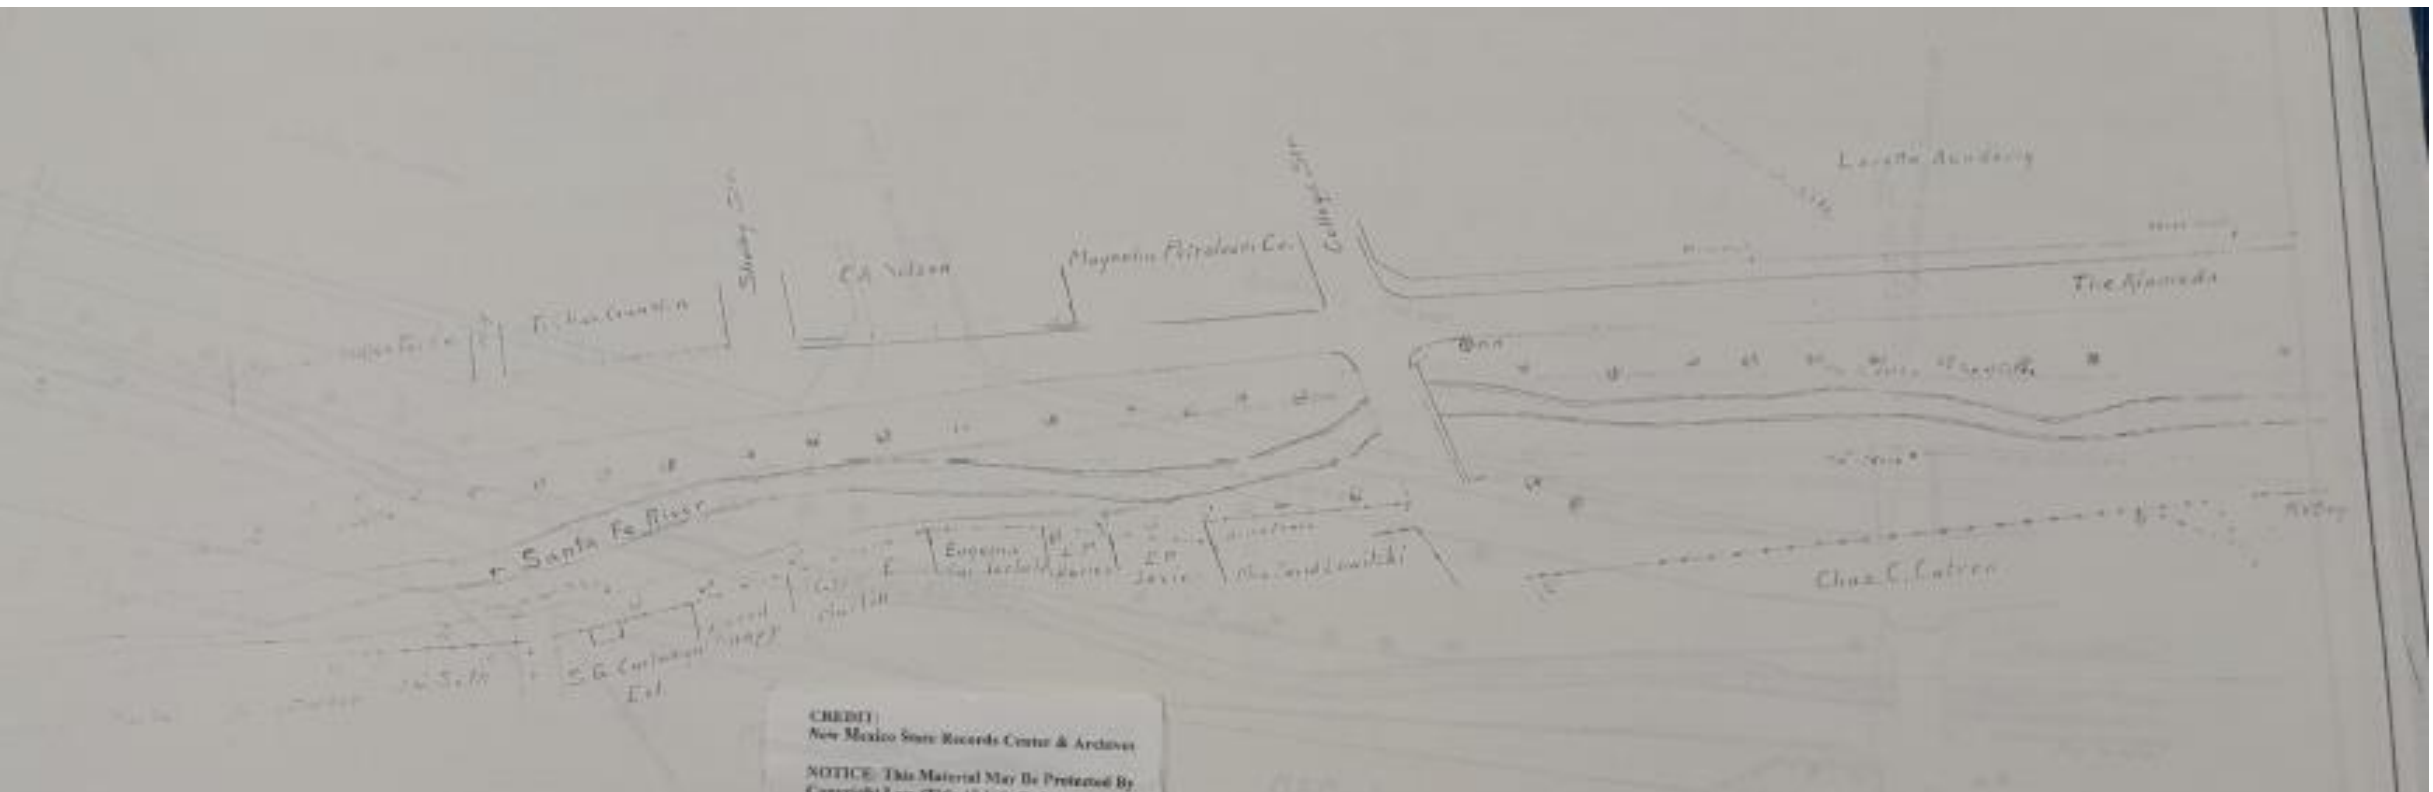

CREDIT:  
New Mexico State Records Center & Archives

NOTICE: This Material May Be Protected By  
Copyright Law (Title 17 U.S. Code)


**PROPOSED**  
**RIVER IMPROVEMENT**  
**CITY OF SANTA FE**

February 1, 1929

Scale 1" = 50'

J. S. & H. W. HARVEY  
 CITY ENGINEERS

Plans from February 1929 project does not show the footbridge as part of the plan

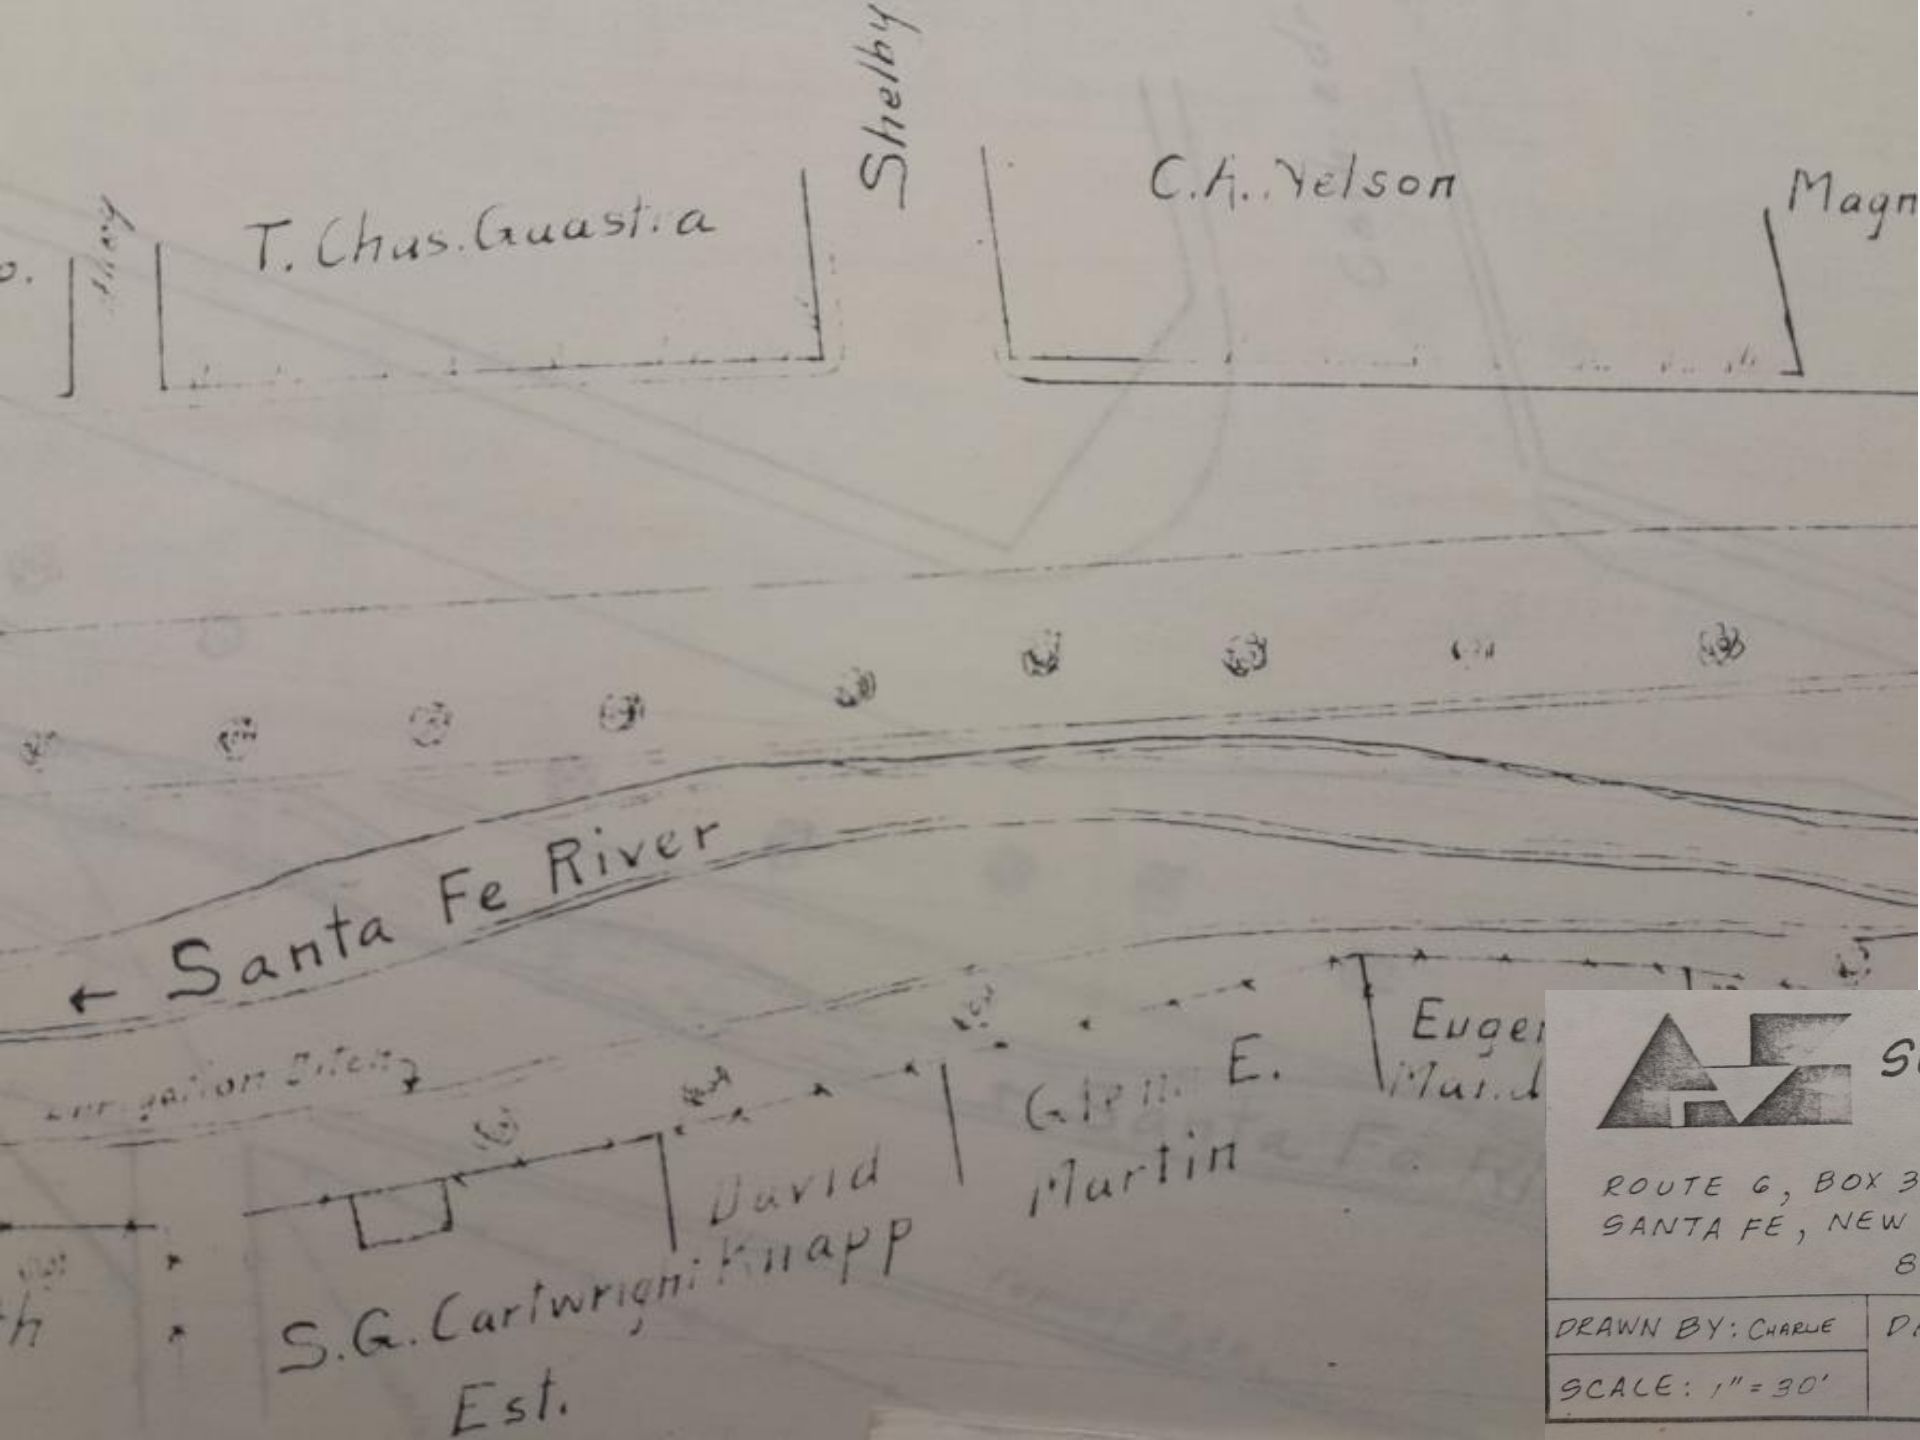

Survey in 1979 does not show the footbridge which was constructed in 1969



**A SURVEYING Company**

ROUTE 6, BOX 31  
SANTA FE, NEW MEXICO  
87501

-TELEPHONE-  
(505) 471-3366

DRAWN BY: CHARLE	DATE: -	SURVEY NO.:
SCALE: 1" = 30'	8-3-79	LS-79-800 SHEET 6 OF 8